
RESPONSE TO REQUEST FOR INFORMATION

DATE: June 10, 2016 **RFI No.** 012

PROJECT: **Waitsfield BRF 013-4(39) - Bridge No. 177**
VT Route 100 over Mad River

TO: Rob Young

FROM: David Kull

RE: RFI #12: Abutment #2: Stem Wall PC5, Tack Welding Rebar

McFarland Johnson (MJ) has reviewed RFI No. 012 and we offer the following response:

1. **Question:** JPC requests permission to tack weld reinforcing rebar in the wing portion of the Unit PC5 at the highlighted intersections on the attached details.

Response: MJ has reviewed the issue, and as discussed with JPC (6/10/2016), RFI #12 is rescinded and the reinforcing bars shall not be tack welded. The reinforcing bars noted in the RFI will be tied.

J.P. CARRARA & SONS, INC.

PRECAST/PRESTRESSED CONCRETE PRODUCTS

REQUEST FOR INFORMATION

TO:	Artie St. Onge	FROM:	Mike Davis / Benjamin Cota
COMPANY:	A.L. St. Onge Contractor	DATE:	6/9/16
FAX NUMBER:	802-326-4005	TOTAL NO. OF PAGES INCLUDING COVER:	3
PHONE NUMBER:	802-326-4792	SENDER'S REFERENCE NUMBER:	RFI #12
RE:	Waitsfield BRF 013-4(39) - Bridge No. 177; VT 100 over Mad River Waitsfield, VT		


☐ URGENT ☒ FOR REVIEW ☒ PLEASE COMMENT ☐ PLEASE REPLY ☐ FOR YOUR USE

PLEASE PROVIDE AND/OR CLARIFY THE FOLLOWING:

RFI #12: Abutment #2: Stem wall PC5, tack welding rebar

JPC requests permission to tack weld reinforcing rebar in the wing portion of the unit PC5 at the highlighted intersections on the attached details.


Please contact us at 802-388-6363 with any questions or to discuss.

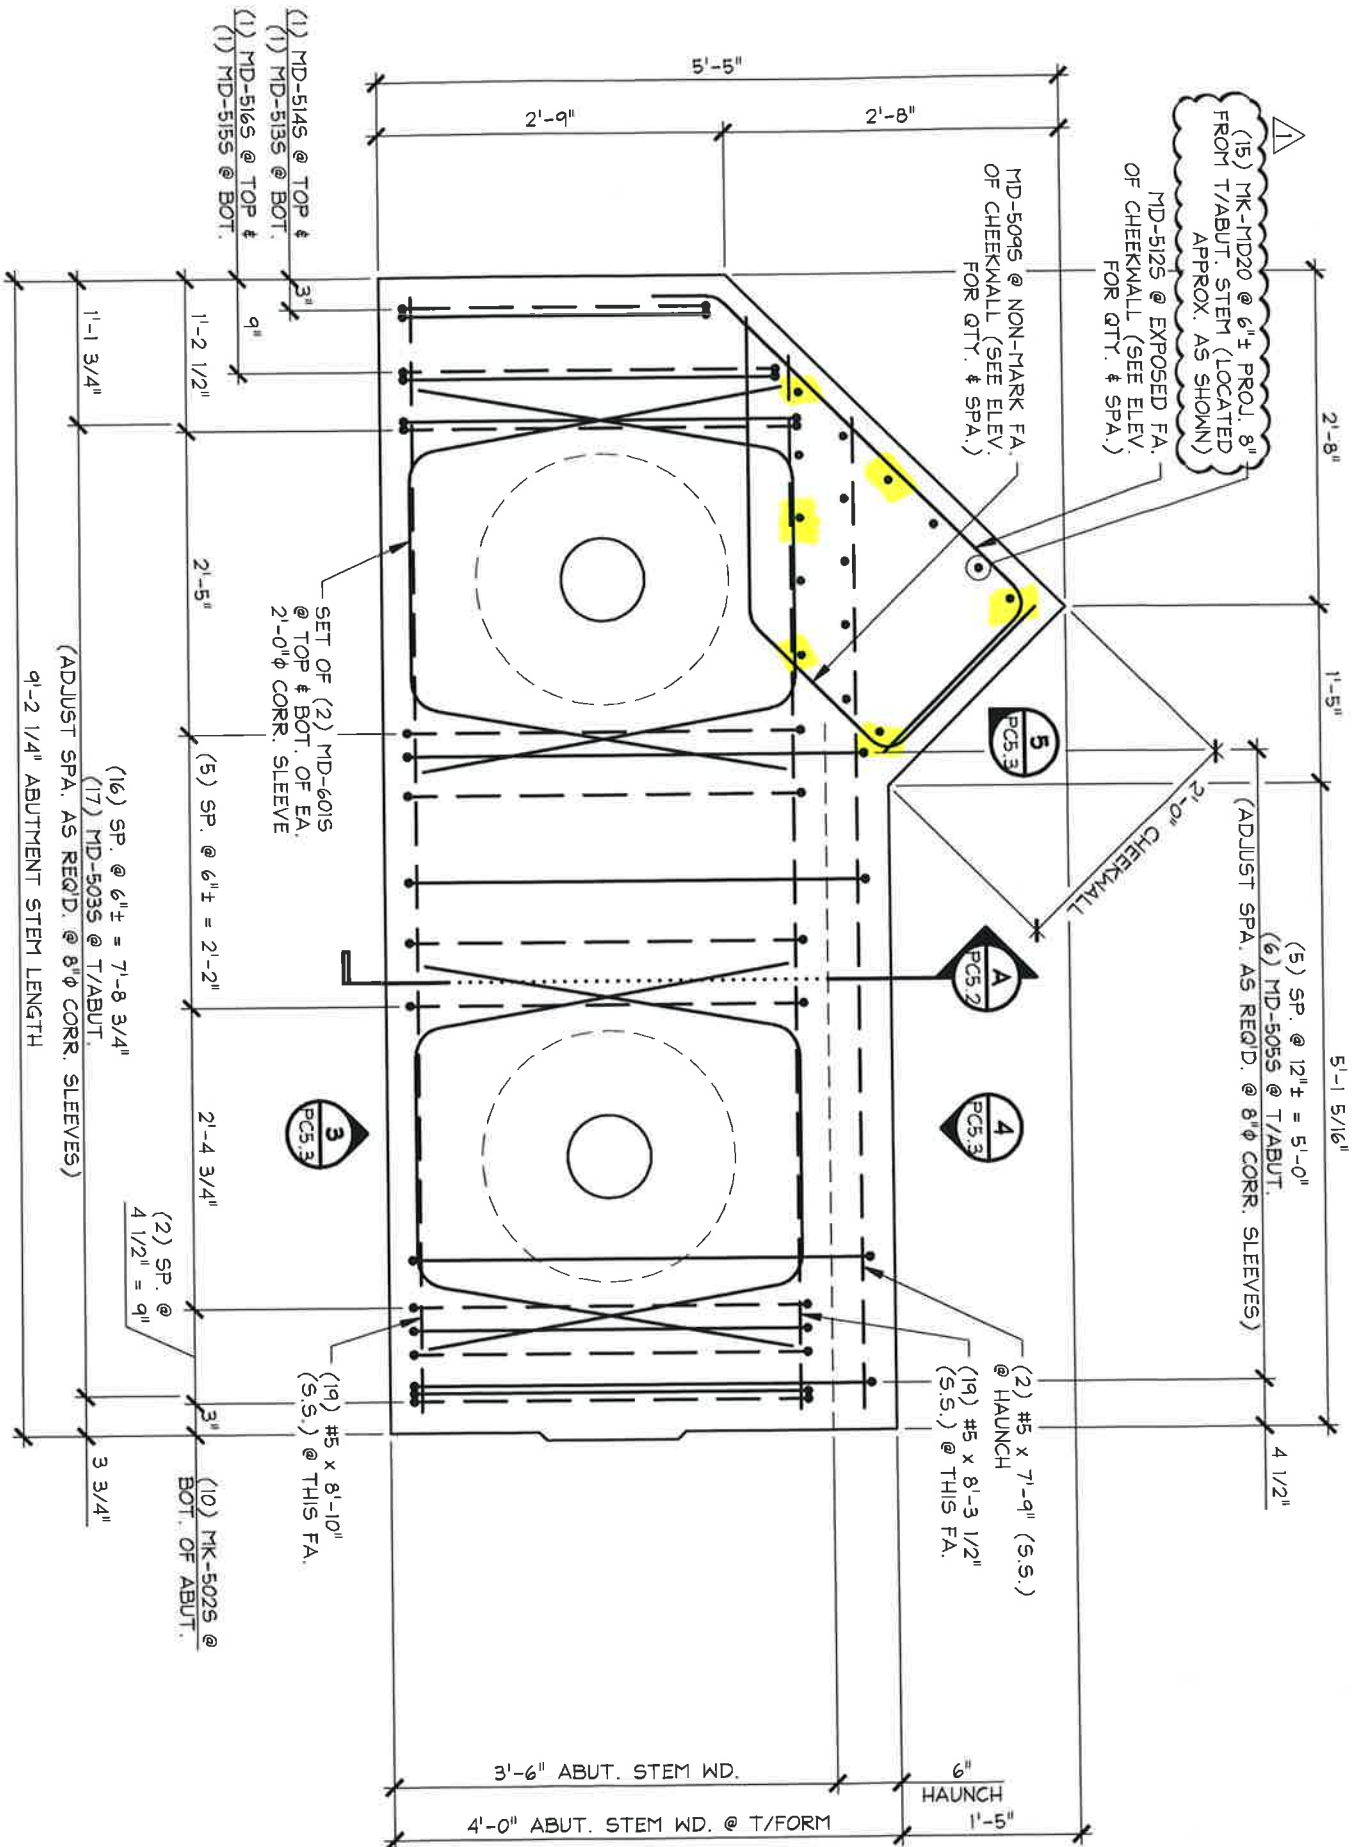

1 REINFORCING PLAN VIEW IN FORM

PC5.2

$$3/4" = 1'-0"$$

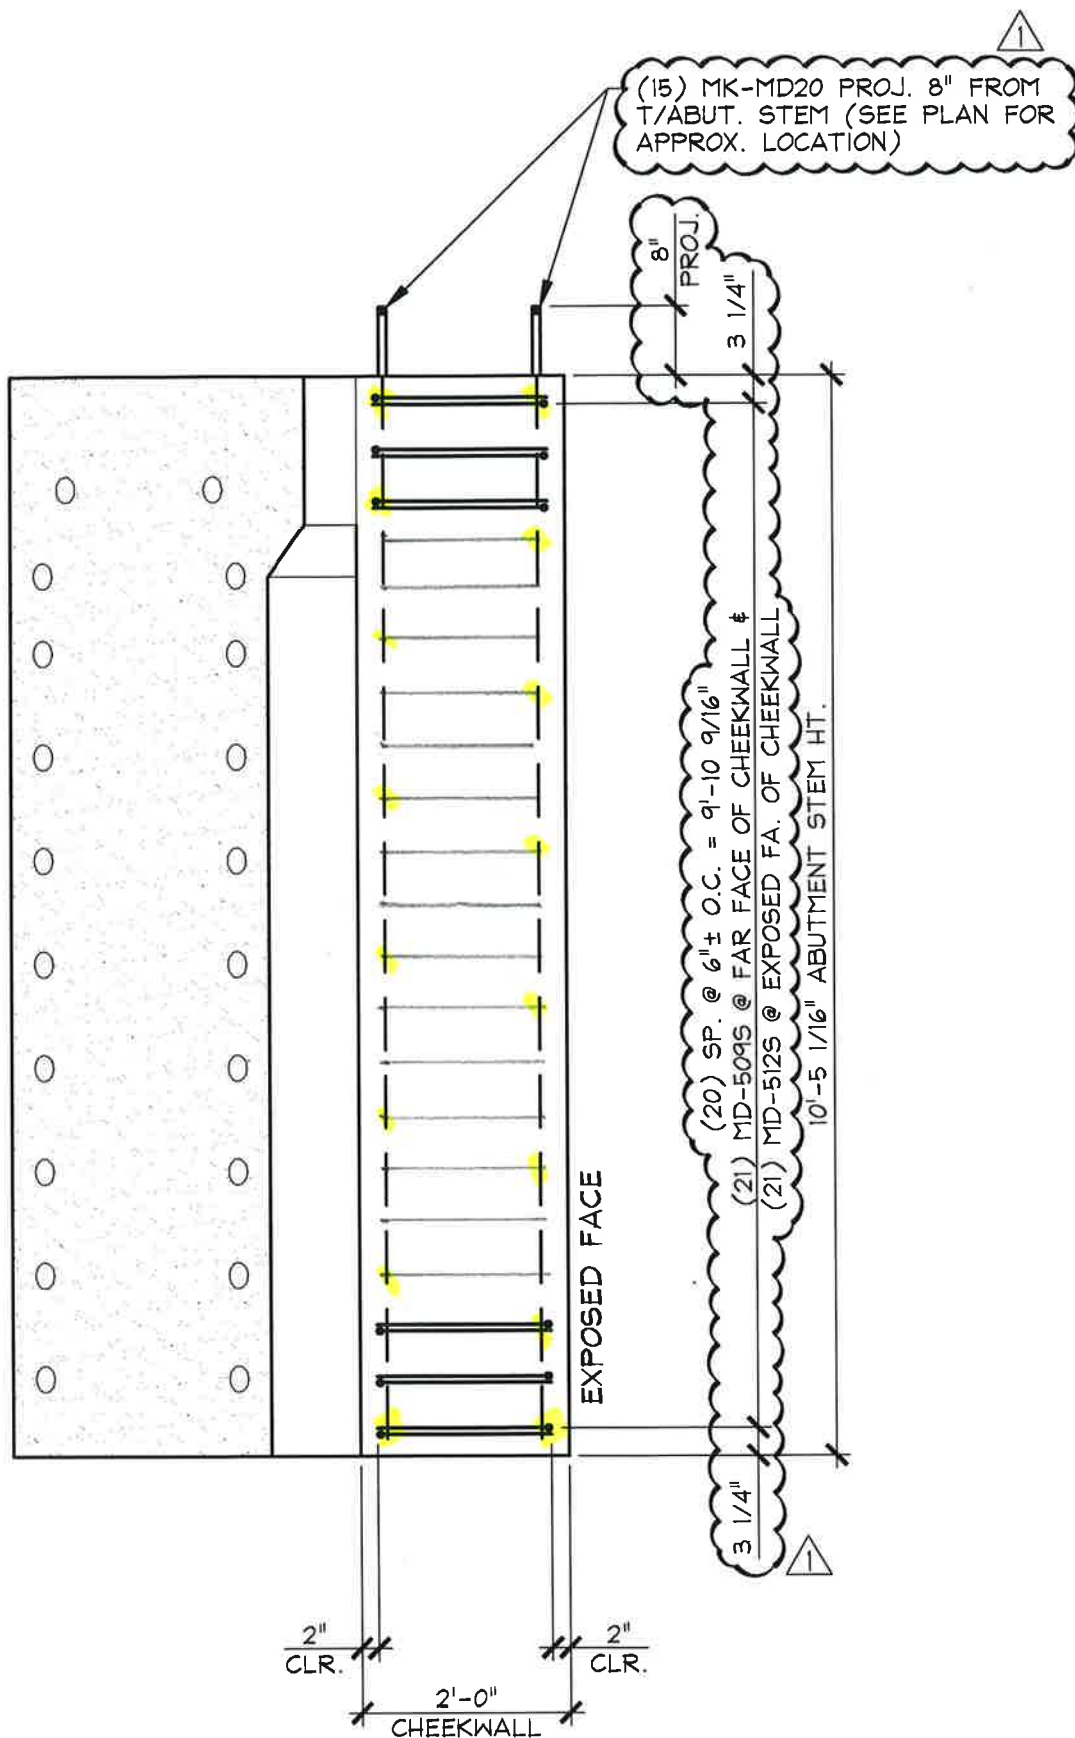

5
PC5.3

CHEEKWALL REINFORCING
ELEVATION

1/2" = 1'-0"